

RECEIVED

SEP 03 2004

SURVEY RECORD REPOSITORY
LANCASTER County

675-269

Official Survey Record

LANCASTER County, Nebraska

Allied Surveying & Mapping, Inc.
Land Surveyors

6120 South 58th Street - Suite "A" - Lincoln, Nebraska 68516


Phone (402) 434-2686
FAX (402) 434-2687

Lots 7 thru 12, Block 1 Gieren's 1st Addition to Walton - Lancaster County, Nebraska

Sheet 1 of 1

Job No. 33552 Section 30 T 10 N, R 8 E of the 6th P.M.
August 13, 2004

NOTE: There is a 30' wide Water Line Easement to Water District No. 2, CASS COUNTY, NEBRASKA the centerline of which is the water facility as constructed. Filed May 28, 1991 as Instrument No. 91-15923.

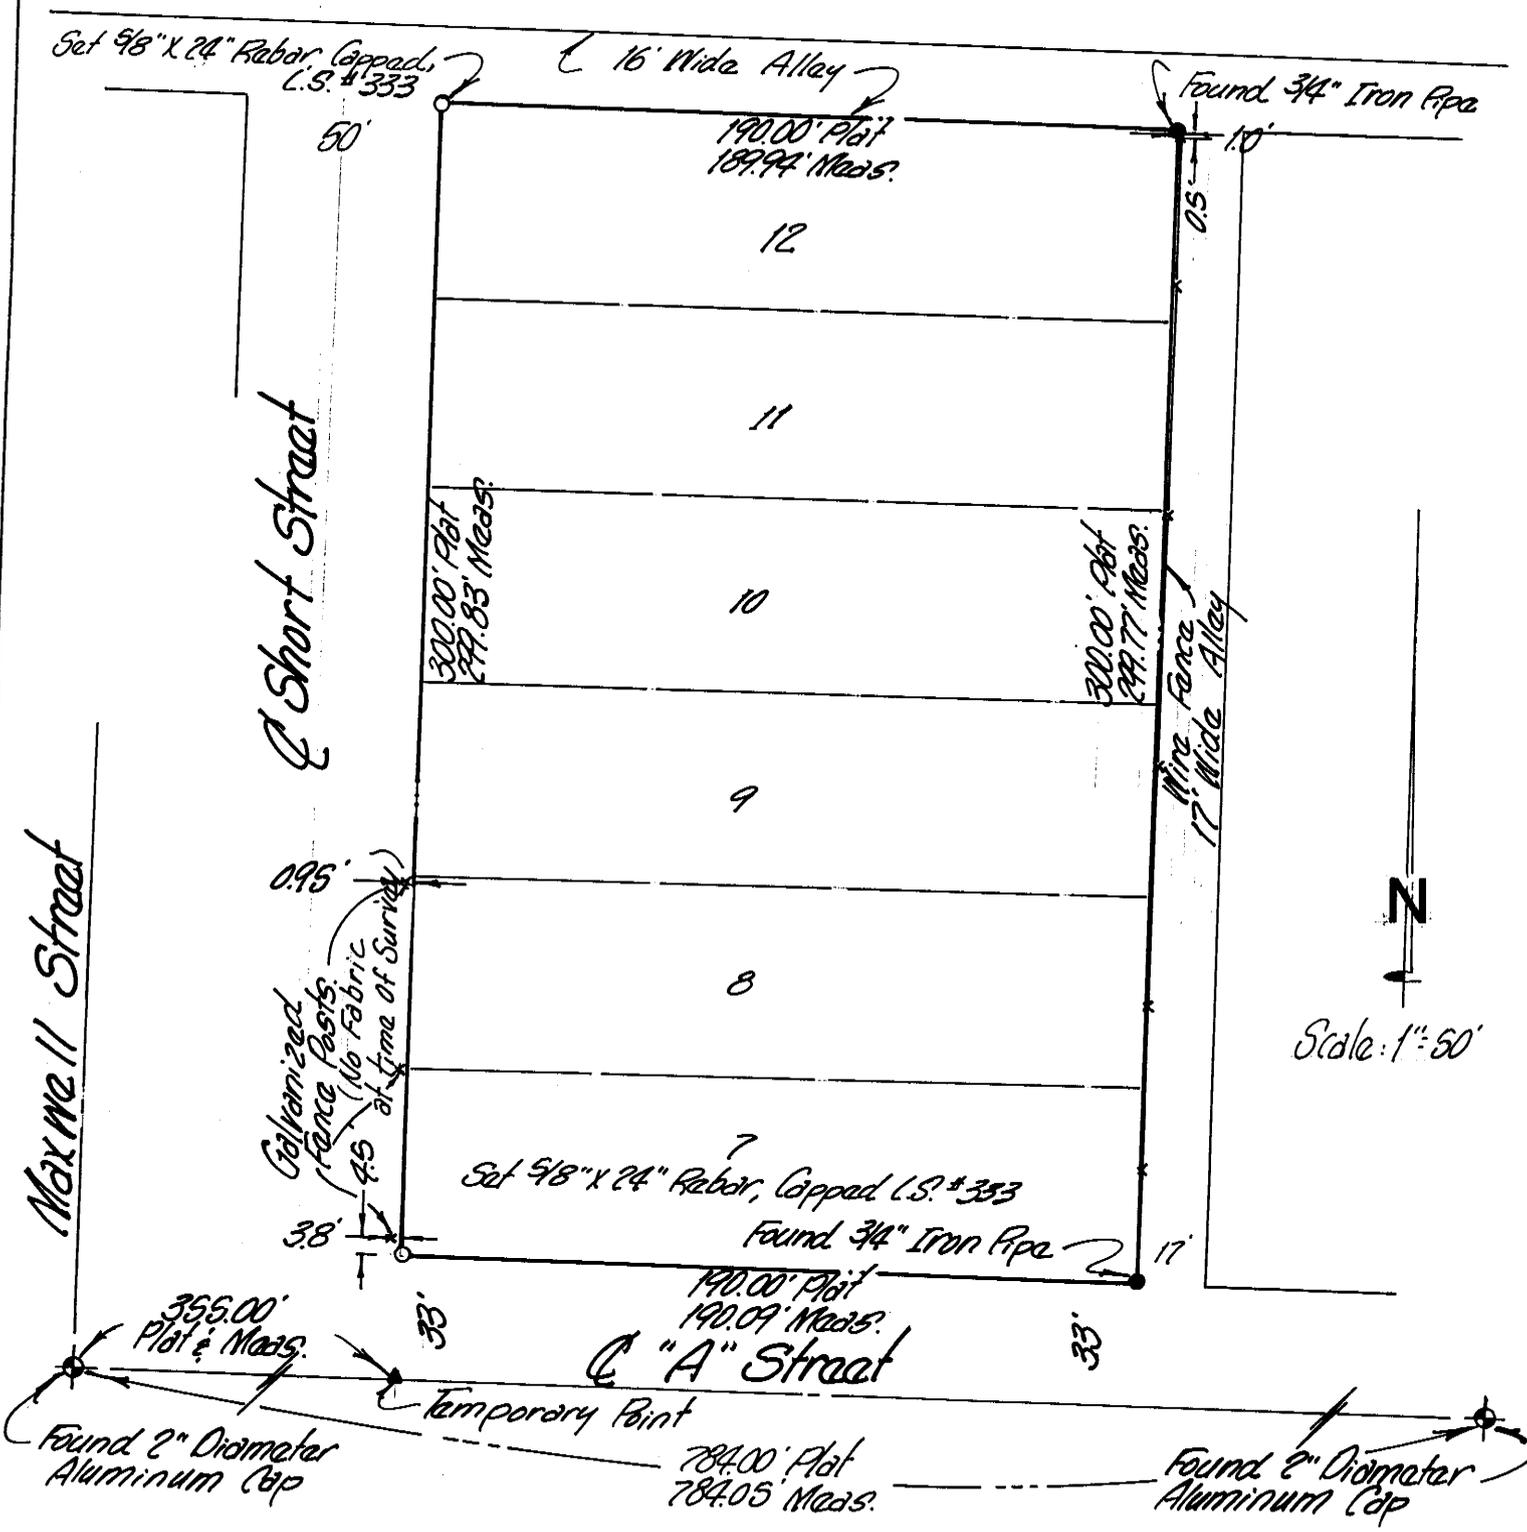

o = Set 5/8" X 24" Capped Rebar
SURVEYORS CERTIFICATE

I hereby certify that I have accurately surveyed the property in the above plat. Iron Rebar were set at points marked o. All dimensions are in feet and decimals of a foot.

• = Monuments Found
Signed this 19th day of August, 2004

NAME Kerry W. Simonds S-333

Surveyor's License
Nebraska L.S. #333

KERRY W. SIMONDS
(SEAL)

