ROSS Engineering, Inc.
ENGINEERS • PLANNERS • SURVEYORS

The Candy Factory
201 North 8th Street, Suite 401
Lincoln, NE 68508

Phone 402-474-7677
FAX 402-474-7678

SURVEY RECORD DRAWING

LEGAL DESCRIPTION

A Survey of all of Lot 5 except the West 64 feet of the South 16 feet and all of Lot 6 except the West 64 feet thereof, Block 2, Eastlawn Addition to the Town of Hickman located in the Southeast Quarter of the Northeast Quarter of Section 33, Township 8 North, Range 7 East of the Sixth Principal Meridian, Lancaster County, Nebraska.

SURVEYOR'S CERTIFICATE

I, Mark A. Streit, a Registered Land Surveyor under the laws of the State of Nebraska, certify the above survey was executed by me, or under my direct supervision. Distances shown are measured in feet and decimals of a foot.

Signed this 8th day of FEBRUARY, 2006.

NEBRASKA REGISTERED LAND SURVEYOR 520 MARK A. STREIT

Mark A. Streit
Registered Professional Land Surveyor
Nebraska L.S. 520

RECEIVED
JUL 31 2006
SURVEY RECORD REPOSITORY
$ 25.00
LANCASTER County
774-043

SURVEY AREA

8,910.39 Square Feet
0.205 Acres+/-

LEGEND

- ◐ = Section & 1/4 Corner
- ● = Corner Found
- ○ = Corner Set (5/8"x24" Rebar with Cap)
- (P) = Platted Distance
- (M) = Measured Distance
- (D) = Deeded Distance
- (R) = Recorded Distance

Field Book: B-29
Date:
Job No.: 85210-A
Sheet: 1 OF 1
Drawn By: BAW

N
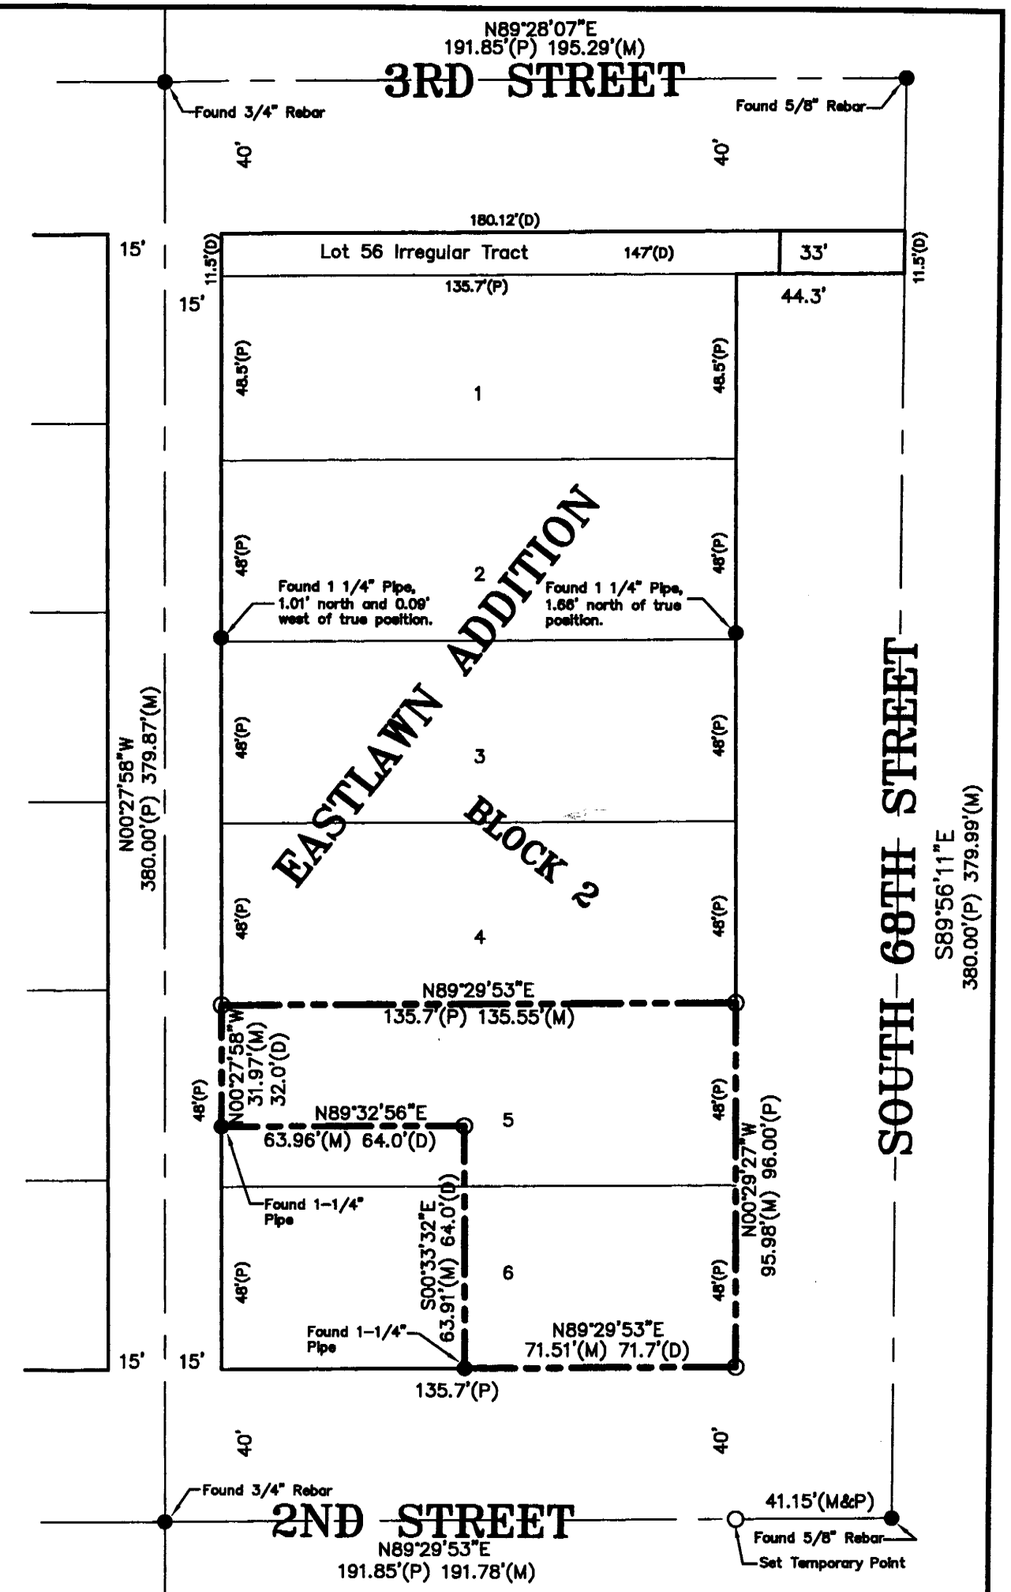
SCALE: 1"= 40'